


Labor and Materials

Copper	Connection	3	\$ 1.33
Lead		4	
Curb	Cock Valve T.S.&V.	3	\$ 1.58
		4	
Service Box	Short 3 1/2 x 4 1/2		\$ 1.36
Old returned	Long 4 1/2 x 5 1/2		
	Butt or Rdway		
26 Ft.	in. Copper	3	\$ 2.47
	Galv. Iron	4	
	Cast Iron		
	Pipe at		
	Nipples		
	Bushings		
	Red'g Inc'g		
	Couplings		
	Union		
	Meter		
	Lbs. Br. Stone		
	Lbs. Sand		
	Bags Cement		
	Paving Brick		
	Lead Joints		
	Leadite Joints		
8	Hrs. Foreman		\$ 1.88
	Hrs. Common Labor	Tapper	\$ 4.00
8	Hrs. Common Labor		\$ 3.60
	Hrs. Mason		
	Hrs. Masons Helper		
	Hrs. Compressor		
	Compensation Ins		\$ 1.29
	Trucking		\$ 5.00
	Builders Use of Water	Patch	\$ 5.00
Total			\$ 22.51

23-3 Labor and Material Report DEC 8 1932

24 Montcalm St

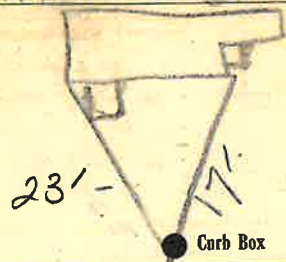

10 Main Elev. of Main at tap 9 1/2

Gate at ● Gate at ●

● Curb Box

old tap dug up and shut off at main

Tax ID # 309.27-6-35

OK

m