


Labor and Materials

1	Copper	} Connection. 3/4"	\$ 1.75	
1	Lead				
1	Curb	} Cock Valve P.S. & V.	} 2 1/4" in	\$ 1.70
1	Service Box				
1	Old returned	} Short 3 1/2 x 4 1/2 Long 4 1/2 x 5 1/2 Buff. or Rdway	}	\$ 1.27	
8	Ft. 3/4 in.				
		} Copper Galv. Iron Cast Iron	} Pipe at 1 1/2 hr.	\$ 1.08	
	Nipples				
	Bushings	\$	
	Red'g Inc'g	} Couplings.....to.....in.at.....	\$	
	Union.....in. at				
	Meter.....in. at	\$	
	Lbs. Br. Stone at	\$	
	Lbs. Sand at	\$	
	Bags Cement at	\$	
	Paving Brick	} Mack Red Asphalt	} at	\$	
	Lead Joints at				
	Leadite Joints at	\$	
7	Hrs. Foreman at	6 1/2 hr.	\$ 1.25	
1	Hrs. Common Labor at	\$.50	
6 1/2	Hrs. Common Labor at	A.S.	\$ 2.93	
	Hrs. Mason at	\$	
	Hrs. Masons Helper at	\$	
	Hrs. Compressor at	\$	
	Compensation Ins	\$.18	
	Trucking	\$ 1.00	
	Builders Use of Water	\$	
Total				\$ 11.26	

1935-127

Labor and Material Report Aug 10 1935

3/4" tap at 29 Mantalm 54

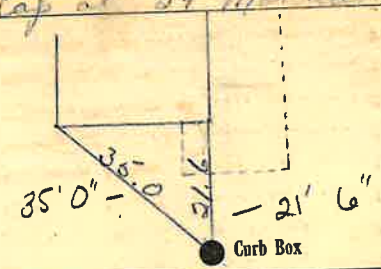

10" Main Elev. of Main at tap 6

Gate at ● ● Gate at

● Curb Box

old tap shut off at main

Tax ID # 309.27-5.8

[Handwritten signature]