

Labor and Materials

1	Copper } Connection <sup>3/4"</sup>	\$ 1.75
1	Lead } Connection <sup>3/4"</sup>	\$ 1.75
1	Curb { Cock Valve T.S.&V. } <sup>3/4" in</sup> ORISEAL	\$ 1.70
1	Service Box { Short 3 1/2 x 4 1/2 } Old returned { Long 4 1/2 x 5 1/2 } Buff. or Rdway	\$ 1.37
26	Ft. in { Copper Galv. Iron } Pipe at 1 1/2 in	\$ 3.51
	Nipples in at	\$
1	Bushings <sup>3/4" to 1/2"</sup> in at	\$ .05
	Red'g } Couplings to in at	\$
	Inc'g } Couplings to in at	\$
	Union in at	\$
	Meter in at	\$
	Lbs. Br. Stone at	\$
	Lbs. Sand at	\$
	Bags Cement at	\$
	Paving Brick { Mack Red Asphalt } at	\$
	Lead Joints at	\$
	Leadite Joints at	\$
5 1/2	Hrs. Foreman at <sup>62 1/2 hr</sup>	\$ 3.44
2 1/2	Hrs. Common Labor at <sup>SP</sup>	\$ 1.75
20 1/2	Hrs. Common Labor at <sup>AS</sup>	\$ 9.73
	Hrs. Mason at	\$
	Hrs. Masons Helper at	\$
	Hrs. Compressor at	\$
	Compensation Ins	\$ 54
	Trucking	\$
	Builders Use of Water	\$

Copper line Replaced Total \$ 23.24


7-8-1972 - Old Broken

1935-179

Labor and Material Report

19

3/4" tap at <sup>Aug 10</sup> ~~at~~ <sup>Manhole 54</sup>

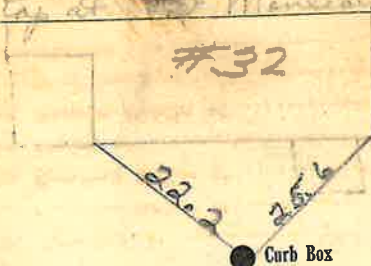

10" Main

Elev of Main at tap 6

Gate at ●

● Gate at

● Curb Box

old tap what off at main.

Tax ID # 309.27-6-38