


Labor and Materials

1	Copper	}	Connection ^{3/4}	\$ 1.25
1	Lead			
1	Curb	}	Cock Valve T.S.&V. ^{3/4} in	\$ 1.70
1	Service Box			
	Old returned	}	Short 3 1/2 x 4 1/2	\$ 1.37
			Long 4 1/2 x 5 1/2	
			Buff. or Rdway	
24	Ft.	}	Copper Pipe at 13 1/2 x	\$ 2.24
			Galv. Iron	
			Cast Iron	
	Nipples		in. at	\$
	Bushings		to in. at	\$
	Red'g Inc'g	}	Couplings	to in. at \$
	Union		in. at	\$
	Meter		in. at	\$
	Lbs. Br. Stone		at	\$
	Lbs. Sand		at	\$
	Bags Cement		at	\$
	Paving Brick	}	Mack	at \$
			Red	
			Asphalt	
	Lead Joints		at	\$
	Leadite Joints		at	\$
5 1/2	Hrs. Foreman		at 6 1/2 hr.	\$ 3.44
3 1/2	Hrs. Common Labor		at 5 hr.	\$ 1.75
2 0 1/2	Hrs. Common Labor		at 4 hr.	\$ 9.23
	Hrs. Mason		at	\$
	Hrs. Masons Helper		at	\$
	Hrs. Compressor		at	\$
	Compensation Ins			\$ 54
	Trucking			\$ 1
	Builders Use of Water			\$

Total \$ 23.57

3/4 tap at 34 Montcalm St

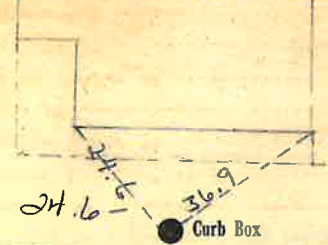

10" Main Elev of Main at tap 6'

Gate at ● ● Gate at

● Curb Box

old shut off

TJ

TAX ID# 309.27-6-39