

Labor and Materials


1	Lead Connection		\$.
1	Curb Cock		\$.
	Service Box	{ Short 31 x 41 Long 41 x 61	\$.
	Old returned	{ Buffalo	
24	Ft.	in. G. I. Pipe at 1/4	\$.
	Nipples	in. at	\$.
	Bushings	1 to 1/2 in. at	\$.
	Red'g Coup	to in. at	\$.
	Inc'g Coup	to in. at	\$.
	Union	in. at	\$.
	Meter	in. at	\$.
	Cu. Yds. Br. Stone	at	\$.
	Cu. Yds. Sand	at	\$.
	Bags Cement	at	\$.
	Paving Brick	{ Mack Red Asphalt } at	\$.
3	Hrs. Foreman	at	\$.
6	Hrs. Common Labor	at	\$.
	Hrs. Mason	at	\$.
	Hrs.	at	\$.
	Hrs.	at	\$.
	Builders' Use of Water		\$.
	<i>Truck 1.00</i>		\$.
			\$.
			\$.
			\$.
			\$.
Total			\$ 13.67

23

Labor and Material Report

1924

36 Montcalm St.

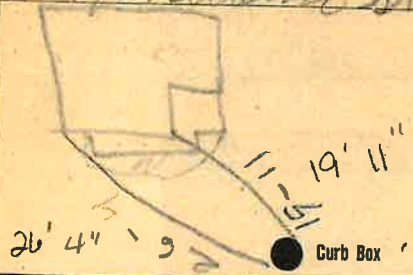

Main

Elev. of
Main at tap

Gate at ●

● Gate at

● Curb Box

Tax ID# 309.27-6-40