

### Labor and Materials

1	Copper	} Connection 3/4"	\$ 1.25
1	Lead		
1	Curb	} 3/4 in	\$ 1.70
	{ Cock Valve T.S.&V.		
1	Service Box	} Short 3 1/2 x 4 1/2 Long 4 1/2 x 5 1/2	\$ 1.37
	Old returned		{ Buff. or Rdway
24	Ft. in.	{ Copper Galv. Iron Cast Iron	Pipe at 13 1/2 \$ 3.24
	Nipples	in. at	\$
1	Bushings	3/4 to 1/2 in. at	\$ .85
	Red's Inc's	{ Couplings.....to.....in. at	\$
	Union	in. at	\$
	Meter	in. at	\$
	Lbs. Br. Stone	at	\$
	Lbs. Sand	at	\$
	Bags Cement	at	\$
	Paving Brick	{ Mack Red Asphalt	at \$
	Lead Joints	at	\$
	Leadite Joints	at	\$
5 1/2	Hrs. Foreman	at 6 1/2	\$ 3.44
3 1/2	Hrs. Common Labor	at 50	\$ 1.75
20 1/2	Hrs. Common Labor	at 45	\$ 9.23
	Hrs. Mason	at	\$
	Hrs. Masons Helper	at	\$
	Hrs. Compressor	at	\$
	Compensation Ins		\$ 54
	Trucking		\$ 1-
	Builders Use of Water		\$
Total			\$ 73.57


1935-179

Labor and Material Report

Aug 24

1935

3/4 tap at 38 Montcalm St.

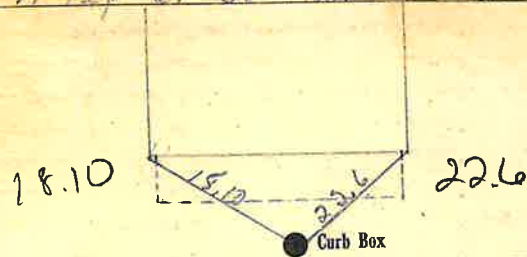

10" Main

Elev of Main at tap 5 1/2'

Gate at ●

● Gate at

● Curb Box

Tax ID # 309.27-6-41  
old shut off at main

*JTB*