

Labor and Materials

| | | | | |
|------------------------------|-------------------------------|--------------|--------------|---|
|Copper | } Connection 1" | | \$ 3.50 | |
|Lead | | | | |
|Curb | } Cock Valve T.S.&V. | } 1" in |\$ 3.06 | |
|Service Box | | | | } Short 3 1/2 x 4 1/2 Long 4 1/2 x 5 1/2 Buff. or Rdway |
|Old returned | | | | |
|8 Ft. 1" in. | } Copper Galv. Iron Cast Iron | } Pipe at 23 |\$ 1.84 | |
|Nipples | | | | |
|Bushings |to |in. at |\$ | |
|Red'g Inc'g | } Couplings |to |in. at |\$ |
|Union | | | | |
|Meter |in. at |\$ | | |
|Lbs. Br. Stone | at |\$ | | |
|Lbs. Sand | at |\$ | | |
|Bags Cement | at |\$ | | |
|Paving Brick | } Mack Red Asphalt | } at |\$ | |
|Lead Joints | | | | at |
|Leadite Joints | at |\$ | | |
|7 Hrs. Foreman | at | 6 1/2 | \$ 1.25 | |
|1 Hrs. Common Labor | at | | \$.50 | |
|6 1/2 Hrs. Common Labor | at | 45 | \$ 2.93 | |
|Hrs. Mason | at | | \$ | |
|Hrs. Masons Helper | at | | \$ | |
|Hrs. Compressor | at | | \$ | |
|Compensation Ins | | | \$.18 | |
|Trucking | | | \$ 1.- | |
|Builders Use of Water | | | \$ | |

Total \$ 15.71


1935-114

Labor and Material Report

Aug 10

1935

1" tap at 5 Montcalm St

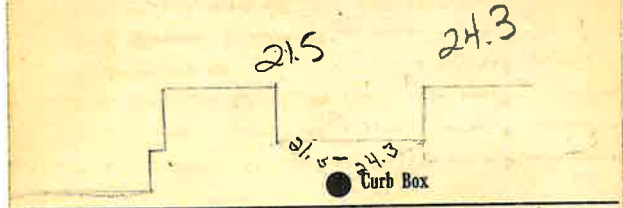

10" Main Elev of Main at tap 5'

Gate at ● ● Gate at

● Curb Box

old tap shut off at main

[Handwritten signature]