


### Labor and Materials

Copper	}	Connection <sup>3/4"</sup> .....	\$.125	
Lead				
Curb	}	Cock Valve T.S.&V. <sup>3/4"</sup> in.....	\$.170	
Service Box		Short 3 1/2 x 4 1/2	}	\$.137
Old returned	Long 4 1/2 x 5 1/2	Buff. or Rdway		
120 Ft.	}	Copper Pipe at 13 1/2 r.s.	\$.125	
Nipples		Galv. Iron		
		Cast Iron		
1	}	Bushings <sup>3/4"</sup> to <sup>1/2"</sup> in. at.....	\$.....	
Red'g Inc'g		Couplings..... to..... in. at.....	\$.....	
.....	Union..... in. at.....	\$.....		
.....	Meter..... in. at.....	\$.....		
.....	Lbs. Br. Stone at.....	\$.....		
.....	Lbs. Sand at.....	\$.....		
.....	Bags Cement at.....	\$.....		
.....	}	Paving Brick { Mack Red Asphalt } at.....	\$.....	
.....		Lead Joints at.....	\$.....	
.....	Leadite Joints at.....	\$.....		
2	Hrs. Foreman at..... <sup>6 1/2</sup> .....	\$.125		
1	Hrs. Common Labor at.....	\$.50		
6 1/2	Hrs. Common Labor at..... <sup>As</sup> .....	\$.793		
.....	Hrs. Mason at.....	\$.....		
.....	Hrs. Masons Helper at.....	\$.....		
.....	Hrs. Compressor at.....	\$.....		
.....	Compensation Ins.....	\$.18		
.....	Trucking.....	\$.17		
.....	Builders Use of Water.....	\$.....		
<b>Total</b>			<b>\$.1152</b>	

1934-130

Labor and Material Report Aug 24 1935

*3/4" tap at 41 Mont calm st.*

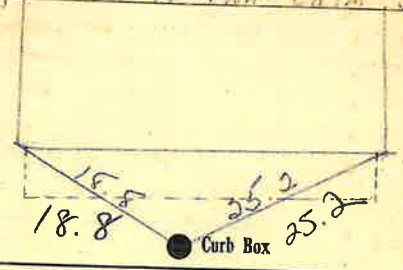

10" Main

Elev of Main at tap <sup>5 1/2</sup>

Gate at ●

● Gate at

● Curb Box

Tax ID # 309.7-11-32

*THO*