


Labor and Materials

.....Copper } Connection.....	?	\$ 1.48
.....Lead }	4	?
.....Curb { Cock Valve }	?	\$ 1.79
.....T.S.&V. }	cf	
.....Service Box { Short 3 1/2 x 4 1/2 }		\$ 1.46
.....Old returned { Long 4 1/2 x 5 1/2 }		
.....Def. or Rdwr. }		
2 6 Ft. in. { Copper } Pipe at	3	\$ 4.84
.....Nipples in. at	4	
.....Bushings to in. at		
.....Red'g } Couplings..... to in. at		
.....Inc'g }		
.....Union..... in. at		
.....Meter..... in. at		
.....Lbs. Br. Stone at		
.....Lbs. Sand at		
.....Bags Cement at		
.....Paving Brick { Mack Red Asphalt } at		
.....Lead Joints at		
.....Leadite Joints at		
5 Hrs. Foreman at		\$ 3.13
6 Hrs. Common Labor at		\$ 3.00
8 Hrs. Common Labor at		\$ 3.60
.....Hrs. Mason at		
.....Hrs. Masons Helper at		
.....Hrs. Compressor at		
.....Compensation Ins		\$ 30
.....Trucking		\$ 1
.....Builders Use of Water Patch		\$ 5
Total \$		25.60

532-111

Labor and Material Report *Sept 14 1932*

42 *Mount Calm*

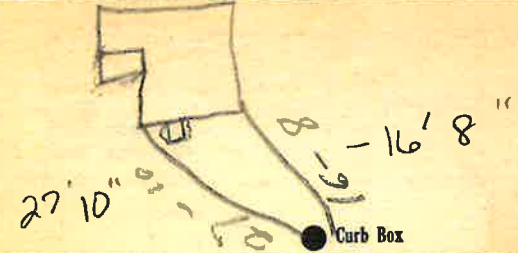

10 Main

Elev. of Main at tap 6

Gate at ●

● Gate at

● Curb Box

Old tap shut off

Tax ID # 309.27-6-43

OK