

**Labor and Materials**


1	Copper	} Connection <sup>3/4"</sup>	.....	\$ 1.25
1	Lead			
1	Curb	} <sup>3/4"</sup> in	.....	\$ 1.70
	Cock Valve T.S.&V.			
1	Service Box	} Short 3 1/2 x 4 1/2	.....	\$ 1.27
	Old returned			
		Buff. or Rdway		
5	Ft.	} Pipe at 13 1/2 cts.	.....	\$ 67
	in.			
	Nipples	..... in. at		\$
1	Bushings	<sup>3/4"</sup> to <sup>1/2"</sup> in. at		\$ .45
	Red'g Inc'g	} Couplings	..... to .....	in. at .....
	Union	..... in. at		\$
	Meter	..... in. at		\$
	Lbs. Br. Stone	at		\$
	Lbs. Sand	at		\$
	Bags Cement	at		\$
	Paving Brick	} at	.....	\$
	Lead Joints			
	Lead Joints	at		\$
	Leadite Joints	at		\$
2	Hrs. Foreman	at <sup>6 1/2</sup>		\$ 1.25
1	Hrs. Common Labor	at		\$ .50
6 1/2	Hrs. Common Labor	at <sup>.45</sup>		\$ 2.93
	Hrs. Mason	at		\$
	Hrs. Masons Helper	at		\$
	Hrs. Compressor	at		\$
	Compensation Ins	.....		\$ .18
	Trucking	.....		\$ 1.50
	Builders Use of Water	.....		\$
Total				\$ 10.91

1935-131

Labor and Material Report Aug 24

1935

<sup>3/4"</sup> Tap at 43 Montcalm St.

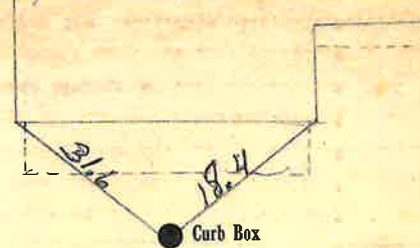

10" Main

Elev. of Main at tap <sup>5 1/2</sup>

Gate at ●

● Gate at

● Curb Box

*old shut off.*

*J.H.*

Tax ID # 309.7-11-31