


Labor and Materials

Copper Connection	3	\$ 2.70
Curb Cock Valve	1	\$ 2.34
Service Box	1	\$ 1.45
Old returned	1	\$ 7.56
28 Ft. in. Copper Pipe at	3	\$
Nipples	in. at	\$
Bushings	to in. at	\$
Red'g Inc'g Couplings	to in. at	\$
Union	in. at	\$
Meter	in. at	\$
Lbs. Br. Stone at		\$
Lbs. Sand at		\$
Bags Cement at		\$
Paving Brick	Mack Red Asphalt at	\$
Lead Joints at		\$
Leadite Joints at		\$ 1.88
3 Hrs. Foreman at		\$ 9.90
72 Hrs. Common Labor at		\$
Hrs. Common Labor at		\$
Hrs. Mason at		\$
Hrs. Mason's Helper at		\$
Hrs. Compressor at		\$ 36
Compensation Ins.		\$ 1
Trucking		\$ 5
Builders' Use of Water	Patch	\$ 5
Total		\$ 32.24

Labor and Material Report

July 30 1930

44 Montcalm Street

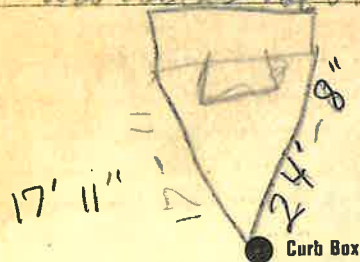

10 Main

Elev of Main at tap

5.3

Gate at ●

● Gate at

● Curb Box

Old Tap disconnected

Tax ID # 309.27-6-44