

Labor and Materials

1...Copper	} Connection <i>3/4"</i>	\$.1.25...
1...Lead			
1...Curb	{ Cock Valve } <i>3/4 in</i>	\$.1.70...
1...Service Box	{ Short $3\frac{1}{2} \times 4\frac{1}{2}$ Long $4\frac{1}{2} \times 5\frac{1}{2}$	\$.1.37...
Old returned			
5...Ft.....in.	{ Copper Galv. Iron Cast Iron } Pipe at <i>12 1/2</i>	\$.68...
.....Nipplesin. at	\$.....
1...Bushings	<i>3/4 to 1/2</i> in. at	\$.05...
.....Red'g Inc'g	} Couplings.....to.....in.at	\$.....
.....Union.....in. at			
.....Meter.....in. at	\$.....
.....Lbs. Br. Stone at	\$.....
.....Lbs. Sand at	\$.....
.....Bags Cement at	\$.....
.....Paving Brick	{ Mack Red Asphalt } at	\$.....
.....Lead Joints at	\$.....
.....Leadite Joints at	\$.....
7...Hrs. Foreman at	<i>6 1/2</i>	\$.1.25...
1...Hrs. Common Labor at	\$.50...
<i>6 1/2</i> Hrs. Common Labor at	<i>.45</i>	\$.2.93...
.....Hrs. Mason at	\$.....
.....Hrs. Masons Helper at	\$.....
.....Hrs. Compressor at	\$.....
.....Compensation Ins	\$.18...
.....Trucking	\$.1.00...
.....Builders Use of Water	\$.....

Total \$10.91...


1935-132

Labor and Material Report

Aug 24

1935

3/4" tap at 47 Montcalm St.

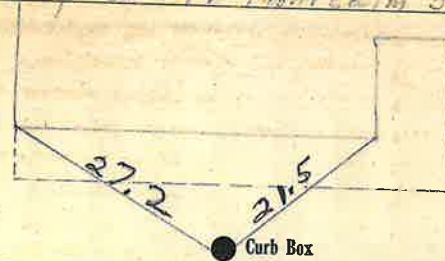

8" Main

Elev. of
Main at tap *5 1/2*

Gate at ●

● Gate at

● Curb Box

Old blank off at main

MM

Tax ID # 309.7-11-29