

Labor and Materials


+	Copper	Connection	3	\$	2.70
+	Lead		4		
+	Curb	Cock Valve	3	\$	2.31
		T.S. & V.	4		
	Service Box	Short 3/4 x 4 1/2		\$	1.45
	Old returned	Long 4 x 5 1/2			
		Buff. or Rdway			
27	Ft.	Copper Galv. Iron Pipe at	3	\$	7.29
		Cast Iron	4		
	Nipples	in. at		\$	
	Bushings	to in. at		\$	
	Red'g Inc'g	Couplings to in. at		\$	
	Union	in. at		\$	
	Meter	in. at		\$	
	Lbs. Br. Stone	at		\$	
	Lbs. Sand	at		\$	
	Bags Cement	at		\$	
	Paving Brick	Mack Red Asphalt at		\$	
	Lead Joints	at		\$	
	Leadite Joints	at		\$	
3	Hrs.	Foreman at		\$	1.88
14	Hrs.	Common Labor at		\$	6.30
	Hrs.	Common Labor at		\$	
	Hrs.	Mason at		\$	
	Hrs.	Mason's Helper at		\$	
	Hrs.	Compressor at		\$	
	Compensation Ins.			\$	25
	Trucking			\$	6.00
	Builders' Use of Water	Patch		\$	5.00
				Total \$	28.26

30-154

Labor and Material Report

Oct 27 1930

48 Mount Calm St

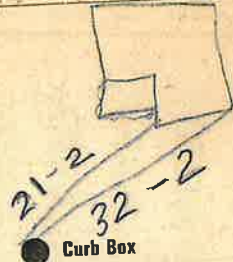

4 Main Elev of Main at tap 5
 Gate at ● Gate at ●

● Curb Box

old Tap
 disconnected