


Labor and Materials

1	Copper } Connection $\frac{3}{4}$ "	\$ 320
	Lead	
1	Curb } Cock Valve } $\frac{3}{4}$ " in	\$ 100
	} T.S. & V. }	
1	Service Box } Short $3\frac{1}{2} \times 4\frac{1}{2}$ "	\$ 130
	Old returned } Long $4\frac{1}{2} \times 5\frac{1}{2}$ "	
	} Buff. or Rdway }	
24	Ft. $\frac{3}{4}$ " in. } Copper } Pipe at	\$ 528
	} Galv. Iron }	
	} Cast Iron }	
	Nipples..... in. at.....	\$
1	Bushings $\frac{3}{4}$ " to $\frac{1}{2}$ " in. at.....	\$ 08
	Red'g } Couplings..... to..... in. at.....	\$
	Inc'g }	
	Union..... in. at.....	\$
	Meter..... in. at.....	\$
	Lbs. Br. Stone at.....	\$
	Lbs. Sand at.....	\$
	Bags Cement at.....	\$
	Paving Brick } (Mack } at.....	\$
	} Red } at.....	
	} Asphalt }	
	Lead Joints at.....	\$
	Leadite Joints at.....	\$
2	Hrs. Foreman at..... 52 52	\$ 120
6	Hrs. Common Labor at..... 50	\$ 300
6	Hrs. Common Labor at..... 40 40 $\frac{5}{8}$	\$ 244
	Hrs. Mason at.....	\$
	Hrs. Mason's Helper at.....	\$
	Hrs. Compressor at.....	\$
	Compensation Ins.....	\$ 19
	Trucking.....	\$ 100
	Builders' Use of Water.....	\$
Total		\$ 1874

26-171

Labor and Material Report Nov. 6 1926

no 6 mounted on st

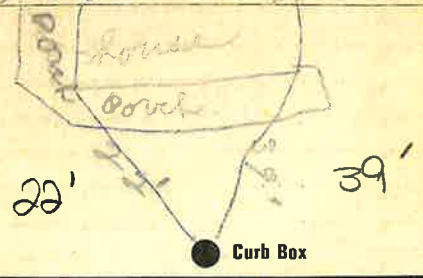

10" Main Elev. of Main at tap 5'

Gate at ● Gate at ●

● Curb Box

Tax ID # 309.27-6-26