

Labor and Materials


1	Copper	} Connection <sup>3/4"</sup>	.....	\$ 1.75
1	Lead			
1	Curb	} <sup>3/4</sup> in	.....	\$ 1.70
	Cock Valve T.S.&V.			
1	Service Box	} Short <sup>3 1/2 x 4 1/2</sup> Long <sup>4 1/2 x 5 1/2</sup> <del>Butt. or Redway</del>	.....	\$ 1.45
	Old returned			
5	Ft. .... in.	} Copper Galv. Iron Cast Iron	Pipe at <sup>1 3/4</sup>	\$ 68
	Nipples ..... in. at			
1	Bushings <sup>3/4</sup> to <sup>1/2</sup> in.	at	.....	\$ .05
	Red'g Inc'g	} Couplings..... to..... in. at	.....	\$
	Union..... in. at			
	Meter..... in. at	.....	\$	
	Lbs. Br. Stone at	.....	\$	
	Lbs. Sand at	.....	\$	
	Bags Cement at	.....	\$	
	Paving Brick	} Mack Red Asphalt	at	\$
	Lead Joints at			
	Leadite Joints at	.....	\$	
2	Hrs. Foreman at	<sup>6 1/2 hr.</sup>	.....	\$ 1.25
1	Hrs. Common Labor at		.....	\$ .50
6 1/2	Hrs. Common Labor at	<sup>4.5</sup>	.....	\$ 2.93
	Hrs. Mason at	.....	\$	
	Hrs. Masons Helper at	.....	\$	
	Hrs. Compressor at	.....	\$	
	Compensation Ins	.....	\$ .18	
	Trucking	.....	\$ 1.-	
	Builders Use of Water	.....	\$	
Total \$ 10.99				

1935-133

Labor and Material Report Aug 24

1935

3/4" Tap at 49 Montecarlo St

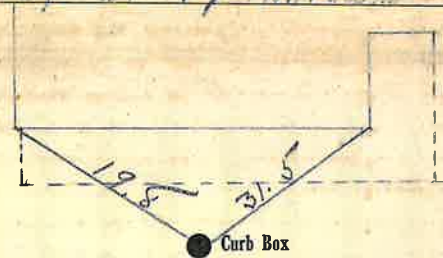

8" Main

Elev. of Main at tap 5 1/2

Gate at ●

● Gate at

● Curb Box

*old shut off at screen*

Tax ID # 309.7-11-28