

Labor and Materials

1...Copper } Connection $\frac{3}{4}$ "	\$ 1.75
1...Lead }	
1...Curb { Cock Valve T.S.&V. } $\frac{3}{4}$ in	\$ 1.70
Service Box { Short $3\frac{1}{2} \times 4\frac{1}{2}$ Long $4\frac{1}{2} \times 5\frac{1}{2}$ Old returned { Buff, or Rdway }	\$
1.7 Ft. in. { Copper Galv. Iron Cast Iron } Pipe at $1\frac{3}{4}$	\$ 1.62
Nipples in. at	\$
Bushings to in. at	\$
Red'g Inc'g { Couplings to in. at	\$
Union in. at	\$
Meter in. at	\$
Lbs. Br. Stone at	\$
Lbs. Sand at	\$
Bags Cement at	\$
Paving Brick { Mack Red Asphalt } at	\$
Lead Joints at	\$
Leadite Joints at	\$
2...Hrs. Foreman at $6\frac{1}{2}$ hr	\$ 1.25
1...Hrs. Common Labor at	\$.52
6.7...Hrs. Common Labor at .45	\$ 2.93
Hrs. Mason at	\$
Hrs. Masons Helper at	\$
Hrs. Compressor at	\$
Compensation Ins	\$.18
Trucking	\$.1-
Builders Use of Water	\$

Total \$10.43


1935-135

Labor and Material Report

Aug 24

1936

$\frac{3}{4}$ " tap at 56 Montcalm

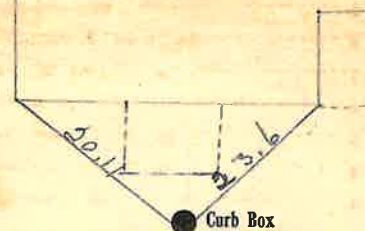

8" Main

Elev. of Main at tap 5

Gate at ●

● Gate at

● Curb Box

old shut off at main

[Signature]

Tax 10# 309.7-11-25