

LABOR AND MATERIALS

1 Copper } Connection $\frac{3}{4}$ " \$
 1 Lead }
 1 Curb } Cock Valve } $\frac{3}{4}$ in. Oriseat. \$
 } T.S. & V. }
 1 Service box { Short $3\frac{1}{2}$ x $4\frac{1}{2}$ }
 Old returned { Long $4\frac{1}{2}$ x $5\frac{1}{2}$ }
 { Buff or Rdway } \$
 26 Ft. $\frac{3}{4}$ in. { Copper } Pipe at \$
 { G. I. }
 { G. I. }
 Nipples _____ in. at \$
 Bushings _____ to _____ in. at \$
 Red'g }
 Inc'g } Coupl'gs _____ to _____ in. at \$
 Union _____ in. at \$
 Meter _____ in. at \$
 Lead Joints at \$
 Compound Joints at \$
 Maintenance Foreman \$
 Hrs. Water Maint. Man-1 at \$
 Hrs. Water Maint. Man-2 at \$
 Hrs. Garage Foreman _____ at \$
 Hrs. Labor _____ at \$
 Hrs. Compressor at \$
 Compensation Ins. at \$ _____ per C \$
 Trucking _____ \$
 Pav't Patch _____ \$
 Tap by Donovan & Co. \$
 _____ \$
 _____ \$
 _____ \$
 O'head _____ \$
 _____ \$


26 Ft. $\frac{3}{4}$ in.

Tap by Donovan & Co.
7-1-70,

Montcalm St. Pl. Ave. No. 56

Name of Owner Berkowitz.

Labor and Mat'l. Report July 2 1970

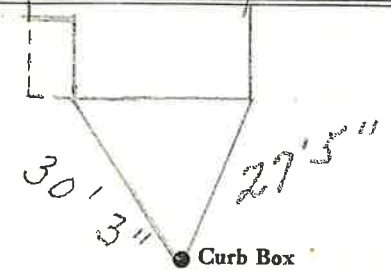

8" Main Elev. of Main at tap 6'

Gate at • • Gate at

• Curb Box