


Labor and Materials

1	Copper } Connection ^{3/4"}	\$ 1.75	
	Lead			
1	Curb { Cock Valve T.S.&V. } ^{3/4} in	\$ 1.70	
1	Service Box { Short 3 1/2 x 4 1/2 Long 4 1/2 x 5 1/2 Buff. or Rdway } Old returned	\$ 1.37	
1.2	Ft. in. { Copper Galv. Iron Cast Iron } Pipe at 13 1/2	\$ 1.62	
	Nipples in. at	\$	
	Bushings to in. at	\$	
	Red'g Inc'g } Couplings to in. at	\$	
	Union in. at	\$	
	Meter in. at	\$	
	Lbs. Br. Stone at	\$	
	Lbs. Sand at	\$	
	Bags Cement at	\$	
	Paving Brick { Mack Red Asphalt } at	\$	
	Lead Joints at	\$	
	Leadite Joints at	\$	
2	Hrs. Foreman at ^{6.25 hr}	\$ 1.25	
1	Hrs. Common Labor at	\$.50	
6.2	Hrs. Common Labor at ^{.45}	\$ 2.92	
	Hrs. Mason at	\$	
	Hrs. Masons Helper at	\$	
	Hrs. Compressor at	\$	
	Compensation Ins	\$.18	
	Trucking	\$.1-	
	Builders Use of Water	\$	
Total			\$ 11.80	

3/4" tap at 57 1/2 Montcalm St.

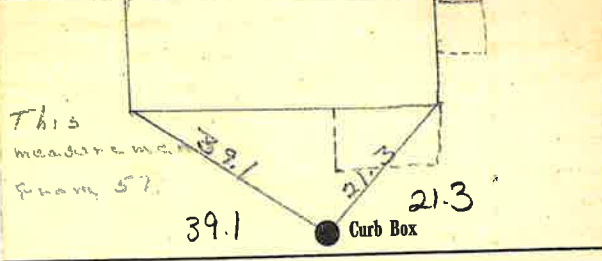

6" Main Elev. of Main at tap 5

Gate at ● ● Gate at

● Curb Box

old shut off at main

JMB

Tax ID # 309.7-11-24.2