


Labor and Materials

1... Lead Connection ^{3/4}	\$.....
1... Curb Cock.....	\$.....
1... Service Box (Short 3 1/2 x 4 1/2 Old returned (Long 4 1/2 x 5 1/2 Buffalo	\$.....
25... Ft. 7" in. G. I. Pipe at.....	\$.....
1... Nipples..... in. at.....	\$.....
1... Bushings 1/2" to 1" in. at.....	\$.....
..... Red'g Coup..... to..... in. at.....	\$.....
..... Inc'g Coup..... to..... in. at.....	\$.....
..... Union..... in. at.....	\$.....
..... Meter..... in. at.....	\$.....
..... Cu. Yds. Br. Stone at.....	\$.....
..... Cu. Yds. Sand at.....	\$.....
..... Bags Cement at.....	\$.....
..... Paving Brick { Mack Red Asphalt } at.....	\$.....
2... Hrs. Foreman at.....	\$.....
5... Hrs. Common Labor at.....	\$.....
..... Hrs. Mason at.....	\$.....
..... Hrs..... at.....	\$.....
..... Hrs..... at.....	\$.....
7.16... Builders' Use of Water.....	\$.....
..... at.....	\$.....
..... at.....	\$.....
..... at.....	\$.....
Total	\$ 13.12

Labor and Material Report

1924

^{TOP}
3/4 58 Montcalm St

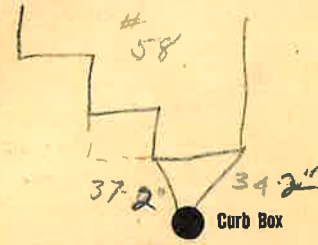

1 Main Elev. of Main at tap 6

Gate at ● ● Gate at

● Curb Box