

Labor and Materials


| | | |
|-------|---|---------|
| 1 | Copper } Connection ^{3/4"} | \$ 1.25 |
| 1 | Lead } | |
| 1 | Curb { Cock Valve T.S.&V. } ^{3/4"} in | \$ 1.70 |
| 1 | Service Box { Short 3 1/2 x 4 1/2 Long 4 1/2 x 5 1/2 Old returned Buff. or Rdway } | \$ 1.37 |
| 16 | Ft. ^{3/4} in. { Copper Galv. Iron Cast Iron } Pipe at | \$ 2.16 |
| | Nipples in. at | \$ |
| 1 | Bushings ^{3/4} to ^{1/2} in. at | \$.25 |
| | Red'g } Couplings to in. at | \$ |
| | Inc'g } | |
| | Union in. at | \$ |
| | Meter in. at | \$ |
| | Lbs. Br. Stone at | \$ |
| | Lbs. Sand at | \$ |
| | Bags Cement at | \$ |
| | Paving Brick { Mack Red Asphalt } at | \$ |
| | Lead Joints at | \$ |
| | Leadite Joints at | \$ |
| 5 1/2 | Hrs. Foreman at ^{6.75} | \$ 3.44 |
| 4 | Hrs. Common Labor at ⁵⁰ | \$ 2.00 |
| 20 | Hrs. Common Labor at ⁴⁵ | \$ 9.00 |
| | Hrs. Mason at | \$ |
| | Hrs. Masons Helper at | \$ |
| | Hrs. Compressor at | \$ |
| | Compensation Ins | \$.54 |
| | Trucking | \$ 1.00 |
| | Builders Use of Water | \$ |

Total \$22.51

1935-115

Labor and Material Report Aug 10 1934

3/4" tap at 7 Main corner St.

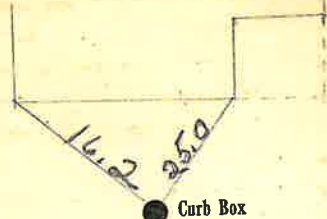

10" Main Elev. of
Main at tap 5

Gate at ● ● Gate at

● Curb Box

Old tap shut off
at main

Tax ID # 309.27-2-27

TH