

Labor and Materials

1...Copper } Connection ^{3/4"}	\$ 1.25
1...Lead }	
1...Curb { Cock Valve } ^{3/4} in	\$ 1.70
{ T.S.&V. }	
1...Service Box { Short ^{3 1/2} x 4 1/2 }	\$ 1.37
Old returned { Long ^{4 1/2} x 5 1/2 }	
{ Buff. or Rdway }	
24 Ft. in. { Copper Galv. Iron } Pipe at ^{13 1/2}	\$ 2.74
{ Cast Iron }	
.....Nipples in. at	\$
.....Bushings to in. at	\$
.....Red'g } Couplings to in. at	\$
.....Inc'g }	
.....Union in. at	\$
.....Meter in. at	\$
.....Lbs. Br. Stone at	\$
.....Lbs. Sand at	\$
.....Bags Cement at	\$
.....Paving Brick { Mack Red Asphalt } at	\$
.....Lead Joints at	\$
.....Leadite Joints at	\$
5 1/2 Hrs. Foreman at ^{67 1/2}	\$ 3.44
3 1/2 Hrs. Common Labor at ⁵⁰	\$ 1.75
20 1/2 Hrs. Common Labor at ⁴⁵	\$ 9.22
.....Hrs. Mason at	\$
.....Hrs. Masons Helper at	\$
.....Hrs. Compressor at	\$
.....Compensation Ins ^{5A}	\$
.....Trucking ^{10.7}	\$
.....Builders Use of Water	\$

Total \$ 23.57.


1935-139

Labor and Material Report

Aug 24

1935

3/4" tap at 62 Montcalm

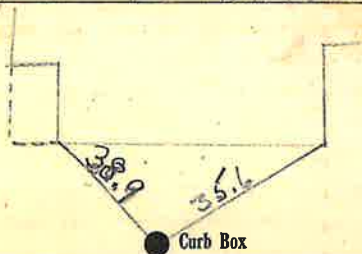

6" Main

Elev. of

Main at tap 5

Gate at ●

● Gate at

● Curb Box

old shut off at main

[Handwritten signature]