

Labor and Materials


| | | | | |
|-------|------------------------|-----------------------------------|---|----------|
| 1 | Copper Lead | Connection | 2 | \$ 2.60 |
| 1 | Curb | Cock Valve T.S. & V. | 4 | \$ 2.27 |
| 1 | Service Box | Short 3 1/2 x 4 1/2 | | \$ 1.38 |
| | Outstanding | Long 4 1/2 x 5 1/2 Built on Rdway | | |
| 9 | Pt. | Copper Galv. Iron | 2 | \$ 1.62 |
| | Nipples | in. at | | \$ |
| | Bushings | to in. at | | \$ |
| | Red'g Inc'g | Couplings to in. at | | \$ |
| | Union | in. at | | \$ |
| | Meter | in. at | | \$ |
| | Lbs. Br. Stone | at | | \$ |
| | Lbs. Sand | at | | \$ |
| | Bags Cement | at | | \$ |
| | Paving Brick | Mack Red Asphalt at | | \$ |
| | Lead Joints | at | | \$ |
| | Leadite Joints | at | | \$ |
| 2 | Hrs. Foreman | at | | \$ 1.25 |
| 8 | Hrs. Common Labor | at | | \$ 3.60 |
| | Hrs. Common Labor | at | | \$ |
| | Hrs. Mason | at | | \$ |
| | Hrs. Mason's Helper | at | | \$ |
| | Hrs. Compressor | at | | \$ |
| | Compensation Ins. | | | \$ 15 |
| | Trucking | | | \$ 1- |
| | Builders' Use of Water | | | \$ 5- |
| Total | | | | \$ 18.87 |

Labor and Material Report

Apr 27 19

67 Mont Calm St

Top for Bottling Works # 69.

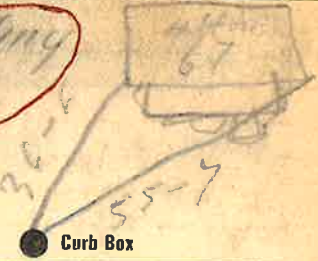

6 Main Eley of Main at tap 52

Gate at ● Gate at ●

● Curb Box

Tax ID # 309.7-11-19

LABOR AND MATERIALS

| | | | |
|--------------------------------------|---------------------------------|--|---------|
| Copper | } Connection | | \$ |
| Lead | | | |
| Curb | { Clock Valve T. S. & V. } | in. | \$ |
| Service box | | { Short 3 1/2 X 4 1/2 Long 4 1/2 X 5 1/2 Buff or Rdway } | |
| Old returned | | | |
| Ft. | { Copper Galv. Iron Cast Iron } | | Pipe at |
| in. | | | |
| Nipples | in. at | | \$ |
| Bushings | to in. at | | \$ |
| Red'g | } Couplings | to in. at | \$ |
| Inc'g | | | |
| Union | in. at | | \$ |
| Meter | in. at | | \$ |
| Lead Joints at | | | \$ |
| Compound Joints at | | | \$ |
| Hrs. Foreman at | | | \$ |
| Hrs. Chauffeur at | | | \$ |
| Hrs. Tapper at | | | \$ |
| Hrs. Labor at | | | \$ |
| Hrs. Labor at | | | \$ |
| Hrs. Compressor at | | | \$ |
| Compensation Ins. | | | \$ |
| Trucking | | | \$ |
| Builders Use of Water | | | \$ |
| Measured by <i>W. A. S. H. S. L.</i> | | | \$ |
| <i>1.600</i> | | | \$ |
| These Lot Measured from | | | \$ |
| <i>#67 Medford St.</i> | | | \$ |


1935-140

Labor and Material Report

Aug 24

1935

3/4" tap at 67 Medford St.

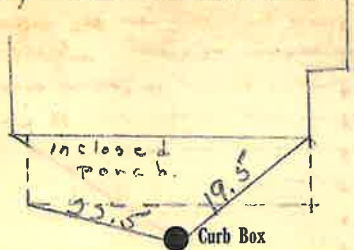

6" Main

Elev of Main at tap 5'

Gate at ●

● Gate at

● Curb Box

old street off at main

MA

Tax ID# 309.7-11-19