


### Labor and Materials

Copper	}	Connection.....	.....	\$
Lead				
Curb	}	Cock Valve T. S. & V. ....	..... in .....	\$
Service Box Old returned				
	}	Short 3½ x 4½	.....	\$
		Long 4½ x 5½		
	}	Buff. or Rdway	.....	\$
9 Ft. ? in.		Copper		
	}	Galv Iron	Pipe at .....	\$
		Cast Iron		
Nipples	..... in. at .....			\$
Bushings	..... to .....	..... in. at .....		\$
Red'g Inc'g	}	Conplings..... to .....	..... in. at .....	\$
Union				
Meter	..... in. at .....			\$
Lead Joints	at .....			\$
Leadite Joints	at .....			\$
Hrs. Foreman	at .....			\$
Hrs. Chauffeur	at .....			\$
Hrs. Tapper	at .....			\$
Hrs. Labor	at .....			\$
Hrs. Labor	at .....			\$
Hrs. Compressor	at .....			\$
Compensation Ins.	.....			\$
Trucking	.....			\$
Builders Use of Water	.....			\$
				\$
				\$
St.  
Pl.  
Ave. No. 73

Name of Owner

Labor and Mat'l. Report 7-12-22 19

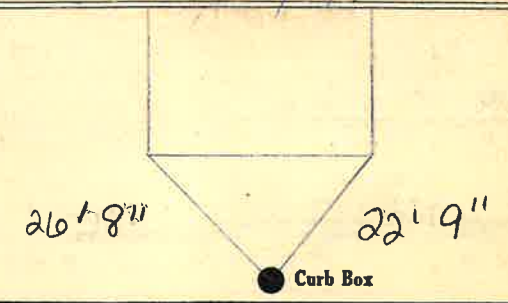

Elev. of  
Main at tap.....

.....Main

Gate at ● ● Gate at

● Curb Box

Tax ID# 309.7-11-17