


LABOR AND MATERIALS

Copper } Connection _____ \$ _____
 Lead }
 Curb } Cock } _____ in. \$ _____
 } Valve }
 } T. S. & V. }
 Service box { Short 3½ x 4½ }
 Old returned { Long 4½ x 5½ } _____ \$ _____
 { Buff or Rdway }
 26 Ft. 2 in. { Copper } Pipe at _____ \$ _____
 { G.I. }
 { G.I. }
 Nipples _____ in. at _____ \$ _____
 Bushings _____ to _____ in. at _____ \$ _____
 Red'g }
 Inc'g } Coupl'gs _____ to _____ in. at _____ \$ _____
 Union _____ in. at _____ \$ _____
 Meter _____ in. at _____ \$ _____
 Lead Joints at _____ \$ _____
 Compound Joints at _____ \$ _____
 Maintenance Foreman _____ \$ _____
 Hrs. Water Maint. Man-1 at _____ \$ _____
 Hrs. Water Maint. Man-2 at _____ \$ _____
 Hrs. Garage Foreman _____ at _____ \$ _____
 Hrs. Labor _____ at _____ \$ _____
 Hrs. Compressor at _____ \$ _____
 Compensation Ins. at \$ _____ per C _____ \$ _____
 Trucking _____ \$ _____
 Pav't Patch _____ \$ _____
 _____ \$ _____
 _____ \$ _____
 _____ \$ _____
 _____ \$ _____
 O'head _____ \$ _____
 _____ \$ _____

St. _____
 Pl. _____
 Ave. No. _____
 Montcalm + Cortland

Name of Owner _____
 City of D.F.

Labor and Mat'l. Report _____ 19 87

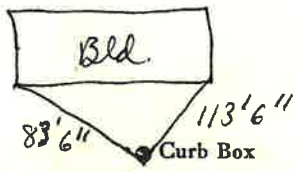

Main _____ Elev. of Main at tap _____
 Gate at • _____ Gate at _____

Tax ID # 309.7-11-15

• Curb Box
 2" Gate Box
 INSURED
 5-12-14

Playgrid.