


Labor and Materials

1	Copper	} Connection ^{3/4"}	\$ 1.25
1	Lead		
1	Curb	} ^{3/4"} in	\$ 1.75
	Cock Valve P.S.&V.		
1	Service Box	} Short 3 1/2 x 4 1/2 Long 4 1/2 x 5 1/2 Buff. or Redway	\$ 1.45
	Old returned		
34	Ft.	} in. { Copper Galv. Iron Cast Iron } Pipe at 12 1/2	\$ 4.59
	Nipples		in. at
1	Bushings	3/4 to 1/2 in. at	\$.45
	Red'g Inc'g	} Couplings.....to.....in.at	\$
	Union		in. at
	Meter	in. at	\$
	Lbs. Br. Stone	at	\$
	Lbs. Sand	at	\$
	Bags Cement	at	\$
	Paving Brick	} at	\$
	Lead Joints		at
	Leadite Joints	at	\$
5 1/2	Hrs. Foreman	at 5 1/2	\$ 3.44
3 1/2	Hrs. Common Labor	at 50	\$ 1.75
2 1/2	Hrs. Common Labor	at 45	\$ 9.23
	Hrs. Mason	at	\$
	Hrs. Masons Helper	at	\$
	Hrs. Compressor	at	\$
	Compensation Ins	at	\$ 50
	Trucking	at	\$ 1.00
	Builders Use of Water	at	\$
Total			\$ 25.00

3/4" tap at 80' Main at 54'

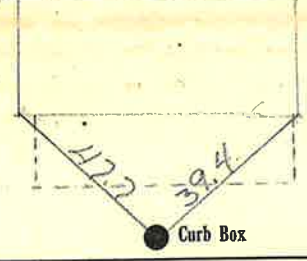

6" Main

Elev. of Main at tap 5'

Gate at ● Gate at ●

● Curb Box

old shut off at main

[Handwritten signature]

Tax ID # 309.7-12-9