

Labor and Materials

1...Copper } Connection $3/4"$	\$ 1.25
1...Lead }	
1...Curb { Cock Valve T.S.&V. } $3/4"$ in	\$ 1.70
1...Service Box { Short $3\frac{1}{2} \times 4\frac{1}{2}$ Long $4\frac{1}{2} \times 5\frac{1}{2}$ Old returned Buff. or Rdway }	\$ 1.37
22...Ft. in. { Copper Galv. Iron Cast Iron } Pipe at $12\frac{1}{2}$	\$ 2.97
.....Nipples in. at	\$
1...Bushings $3/4"$ to $1/2$ in. at	\$.25
.....Red'g } Couplings.....to.....in.at.....	\$
.....Inc'g }	
.....Union.....in. at	\$
.....Meter.....in. at	\$
.....Lbs. Br. Stone at	\$
.....Lbs. Sand at	\$
.....Bags Cement at	\$
.....Paving Brick { Mack Red Asphalt } at	\$
.....Lead Joints at	\$
.....Leadite Joints at	\$
5 1/2 Hrs. Foreman at 6.75	\$ 3.41
3 1/2 Hrs. Common Labor at 50	\$ 1.75
20 1/2 Hrs. Common Labor at 45	\$ 9.23
.....Hrs. Mason at	\$
.....Hrs. Masons Helper at	\$
.....Hrs. Compressor at	\$
.....Compensation Ins	\$.50
.....Trucking	\$ 6.-
.....Builders Use of Water	\$
Total \$73.30.	


1935-143

Labor and Material Report

Aug 24

1936

$3/4"$ Tap at 84 Mont calm St.

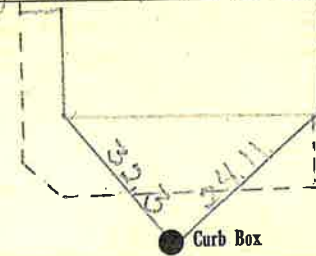

● Curb Box

6" Main

Elev. of Main at tap 5'

Gate at ●

● Gate at

● Curb Box

Old shut off at main
HMB

Tap on Cortland

Tax ID# 309.7-12-12