


Labor and Materials

1	Copper } Connection $\frac{3}{4}$ "	\$ 1.75
1	Lead }	
1	Curb { Cock Valve T.S.&V. } $\frac{3}{4}$ " in	\$ 1.70
1	Service Box { Short $3\frac{1}{2} \times 4\frac{1}{2}$ Long $4\frac{1}{2} \times 5\frac{1}{2}$ Buff. or Rdwy. }	\$ 1.37
1.2	Ft. in { Copper Galv. Iron Cast Iron } Pipe at $\frac{3}{4}$ "	\$ 7.20
	Nipples in at	\$
1	Bushings $\frac{3}{4}$ to $\frac{1}{2}$ in at	\$.25
	Red'g Inc'g } Couplings to in at	\$
	Union in at	\$
	Meter in at	\$
	Lbs. Br. Stone at	\$
	Lbs. Sand at	\$
	Bags Cement at	\$
	Paving Brick { Mack Red Asphalt } at	\$
	Lead Joints at	\$
	Leadite Joints at	\$
$\frac{5}{2}$	Hrs. Foreman at $\frac{6}{2}$	\$ 3.44
$\frac{3}{2}$	Hrs. Common Labor at $\frac{5}{2}$	\$ 1.75
$\frac{20}{2}$	Hrs. Common Labor at $\frac{45}{2}$	\$ 9.23
	Hrs. Mason at	\$
	Hrs. Masons Helper at	\$
	Hrs. Compressor at	\$
	Compensation Ins	\$.50
	Trucking	\$ 1.-
	Builders Use of Water	\$
Total		\$ 22.63

$\frac{3}{4}$ " tap at 85 Montcalm St.

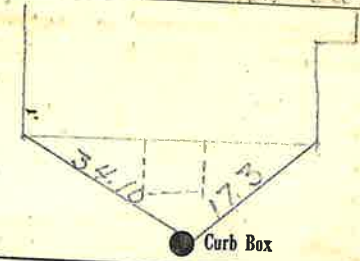

6" Main
 Elev. of Main at tap \checkmark
 Gate at ● Gate at ●

● Curb Box

old shut off at main

[Handwritten signature]

Tax ID# 309.76-29