

LABOR AND MATERIALS


1 Copper } Connection 3/4" \$ _____
~~Lead~~ }
 1 Curb } Cock Valve } 3/4 in. ORISEAL }
 T.S. & V. }
 1 Service box } Short 3 1/2 x 4 1/2 }
 Old returned } Long 4 1/2 x 5 1/2 } 4' x 5' }
 Buff or Rdway } \$ _____ }
 12 Ft. 3/4 in. } Copper } Pipe at _____ \$ _____
 G. I. }
 C. I. }
 Nipples _____ in. at _____ \$ _____
 Bushings _____ to _____ in. at _____ \$ _____
 Red'g }
 Inc'g } Coupl'gs _____ to _____ in. at _____ \$ _____
 Union _____ in. at _____ \$ _____
 Meter _____ in. at _____ \$ _____
 Lead Joints at _____ \$ _____
 Compound Joints at _____ \$ _____
 Maintenance Foreman _____ \$ _____
 Hrs. Water Maint. Man-1 at _____ \$ _____
 Hrs. Water Maint. Man-2 at _____ \$ _____
 Hrs. Garage Foreman _____ at _____ \$ _____
 Hrs. Labor _____ at _____ \$ _____
 Hrs. Compressor at _____ \$ _____
 Compensation Ins. at \$ _____ per C _____ \$ _____
 Trucking _____ \$ _____
 Pav't Patch _____ \$ _____
 TAP MADE BY PECK & CO. \$ _____
 OCT 14-1971 \$ _____
 O'head _____ \$ _____
 _____ \$ _____

Montcalm

St. Pt. Ave. No. 89

Name of Owner
 Sylvia Kinsley

Labor and Mat'l. Report Oct 14 1971

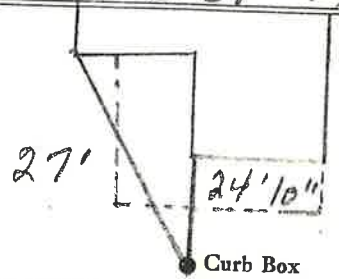

6" Main

Elev. of Main at tap 5'

Gate at • Gate at

• Curb Box

Tax ID # 309.7-6-27