


LABOR AND MATERIALS

Copper } Connection	\$
Lead } Connection	\$
Curb } Clock Valve	}	in.	\$
T. S. & V.			
Service box } Short 3½X4½	}	\$
Old returned } Long 4½X5½			
Buff or Rdway			
Ft.in.	Copper } Pipe at	\$
	Galv. Iron }		
	Cast Iron }		
Nipplesin. at	\$
Bushingstoin. at	\$
Red'g } Couplingstoin. at	\$
Inc'g }			
Unionin. at	\$
Meterin. at	\$
Lead Joints	at	\$
Compound Joints	at	\$
Hrs. Foreman	at	\$
Hrs. Chauffeur	at	\$
Hrs. Tapper	at	\$
Hrs. Labor	at	\$
Hrs. Labor	at	\$
Hrs. Compressor	at	\$
Compensation Ins.		\$
Trucking		\$
Builders Use of Water		\$
<i>#8 8 1/2 Same Curb Box</i>			
		\$
		\$
St. Montcalm
Pl.
Ave. No. 8 1/2

Name of Owner _____

Labor and Mat'l. Report June 1945

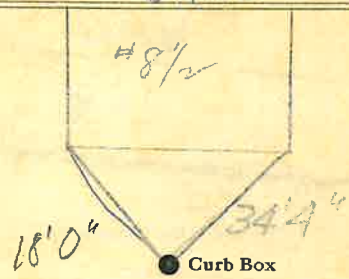

Main Elev. of Main at tap

Gate at ● ● Gate at

● Curb Box