


Labor and Materials

1	Copper } Connection ^{3/4"}	\$ 1.25
1	Lead } Connection ^{3/4"}	\$ 1.25
1	Curb { Cock Valve } ^{3/4} in	\$ 1.70
	{ T.S.&V. }	
	Service Box { Short 3 1/2 x 4 1/2 }	\$
	Old returned { Long 4 1/2 x 5 1/2 }	\$
	{ Buff. or Rdway }	
11	Ft. in { Copper Galv. Iron } Pipe at ^{13 1/2} ft.	\$ 1.49
	{ Cast Iron }	
	Nipples in. at	\$
1	Bushings ^{3/4} to ^{1/2} in. at	\$.45
	Red'g } Couplings to in. at	\$
	Inc'g }	
	Union in. at	\$
	Meter in. at	\$
	Lbs. Br. Stone at	\$
	Lbs. Sand at	\$
	Bags Cement at	\$
	Paving Brick { Mack Red Asphalt } at	\$
	Lead Joints at	\$
	Leadite Joints at	\$
7	Hrs. Foreman at ^{6 1/2}	\$ 1.25
1	Hrs. Common Labor at	\$.50
6 1/2	Hrs. Common Labor at ^{AS}	\$ 2.93
	Hrs. Mason at	\$
	Hrs. Masons Helper at	\$
	Hrs. Compressor at	\$
	Compensation Ins	\$.18
	Trucking	\$ 1.-
	Builders Use of Water	\$
	Total	\$ 10.35

3/4" tap at ⁹¹ 59 Mont calm St.

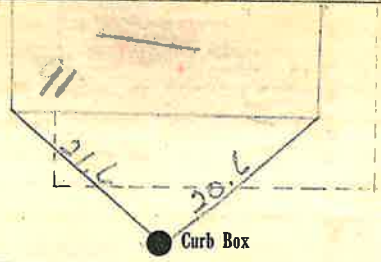

6" Main Elev of Main at tap .5
 Gate at ● Gate at ●

● Curb Box
 old shut off at main
 off in on position
 Tax ID# 309.7-6-26