


Labor and Materials

1..	Copper	} Connection ^{3/4"}	\$ 1.25	...
1..	Lead				
1..	Curb	} ^{3/4"} in	\$ 1.70	...
	Cock Valve T.S.&V.				
	Service Box	} Short 3 1/2 x 4 1/2 Long 4 1/2 x 5 1/2	\$...
	Old returned		Buff. or Rdway		
25	Ft.....	in. { Copper Galv. Iron } Pipe at 12 1/2	\$ 3.38	...
	Nipples in. at	\$...
1..	Bushings 3/4 to 1/2 in. at	\$.05	...
	Red'g Inc'g	} Couplings..... to..... in. at	\$...
	Union in. at	\$...
	Meter in. at	\$...
	Lbs. Br. Stone	at	\$...
	Lbs. Sand	at	\$...
	Bags Cement	at	\$...
	Paving Brick	} Mack Red Asphalt	at	\$
	Lead Joints		at	\$
	Leadite Joints	at	\$...
5 1/2	Hrs. Foreman	at 6 1/2	\$ 3.44	...
3 1/2	Hrs. Common Labor	at 50	\$ 1.75	...
25 1/2	Hrs. Common Labor	at 45	\$ 9.23	...
	Hrs. Mason	at	\$...
	Hrs. Masons Helper	at	\$...
	Hrs. Compressor	at	\$...
	Compensation Ins	\$ 54	...
	Trucking	\$ 1.-	...
	Builders Use of Water	\$...
Total \$				22.34	...

1935-146

Labor and Material Report *Aug 24* 19*35*

3/4" tap at 92 Mendocino St.

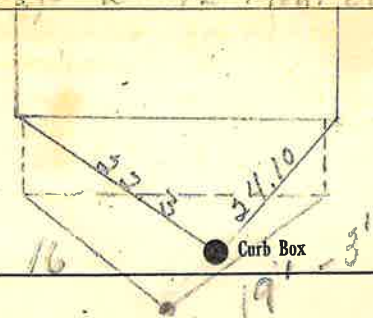

6" Main

Elev of Main at tap *5*

Gate at ●

● Gate at

● Curb Box

Old Shut off at main

1770

Tax ID# 309.7-12-15