

Labor and Materials

1	Copper } Connection.....	3	\$ 3.20
	Lead }		
1	Curb } Cock Valve } 3 in.....		\$ 1.00
	} T. S. & V. }		
1	Service Box } Short 3 1/2 x 4 }		\$ 1.30
	} Long 4 1/2 x 5 1/2 }		
	Old returned } Buff. or Rdway }		\$ 5.72
2 1/2	Ft. } in. } Copper } Pipe at.....		
	} } Galv. Iron }		
	} } Cast Iron }		
	Nipples..... in. at.....		\$
	Bushings..... to..... in. at.....		\$
	Red'g } Couplings..... to..... in. at.....		\$
	Inc'g }		\$
	Union..... in. at.....		\$
	Meter..... in. at.....		\$
	Lbs. Br. Stone at.....		\$
	Lbs. Sand at.....		\$
	Bags Cement at.....		\$
	Paving Brick } Mack } at.....		\$
	} Red }		
	} Asphalt }		
	Lead Joints at.....		\$
	Leadite Joints at.....		\$
2	Hrs. Foreman at.....	6.21.2-	\$ 1.25
	Hrs. Common Labor at.....		\$
1.0	Hrs. Common Labor at.....	40 1/8	\$ 4.15
	Hrs. Mason at.....		\$
	Hrs. Mason's Helper at.....		\$
	Hrs. Compressor at.....		\$
	Compensation Ins.....		\$ 1.44
1	Trucking.....		\$ 1.00
	Builders' Use of Water.....		\$
	Total		\$ 19.66


27-36

Labor and Material Report

May 5

1927

92 1/2 Montclair st

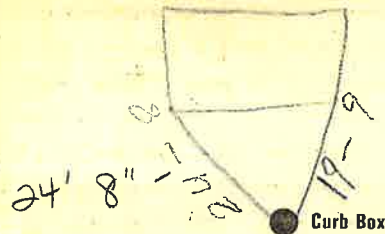

Main

Elev. of Main at tap 4 1/2

Gate at ●

● Gate at

● Curb Box

New house

Tax ID# 309.7-12-16