

Labor and Materials


1	Copper	} Connection ^{3/4"}	\$.1.25
1	Lead			
1	Curb	} ^{3/4"} in	\$.1.70
	{ Cock Valve T.S.&V.			
1	Service Box	} Short 3 1/2 x 4 1/2	\$.1.37
	Old returned			
2.7	Ft.	} in { Copper Galv. Iron Cast-Iron } Pipe at 13 1/2 r.s.	\$.3.65
	Nipples			
	Bushings to	in. at
	Red'g Inc'g	} Couplings to	in. at
	Union			
	Meter in. at
	Lbs. Br. Stone	at
	Lbs. Sand	at
	Bags Cement	at
	Paving Brick	} at
	Lead Joints			
	Leadite Joints	at
5 1/2	Hrs. Foreman	at 62 1/2	\$.3.44
2 1/2	Hrs. Common Labor	at 50	\$.1.75
20 1/2	Hrs. Common Labor	at 45	\$.9.23
	Hrs. Mason	at
	Hrs. Masons Helper	at
	Hrs. Compressor	at
	Compensation Ins	\$.54
	Trucking	\$.1.15
	Builders Use of Water

Total \$229.3

1035-147

Labor and Material Report *Aug 24* 193*0*

3/4" Tap at 24 Montcalm St.

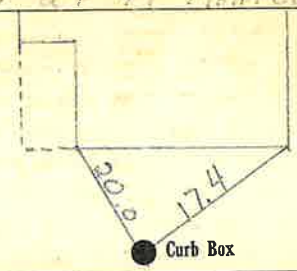

6" Main Elev. of Main at tap 5

Gate at ● ● Gate at

● Curb Box

old shut off at main

MD

Tax ID# 309.7-12-17