


# LABOR AND MATERIALS

_____	Copper	} Connection _____	\$ _____
_____	Lead		
_____	Curb	} _____ in. _____	\$ _____
	Cock		
	Valve T.S. & V.		
_____	Service box	{ Short 3-1/2 x 4-1/2 }	\$ _____
_____	Old returned		{ Long 4-1/2 x 5-1/2 }
<u>34</u>	Ft. <u>5</u>	} Pipe at _____	\$ _____
	in.		{ Copper
			{ G.I. / C.I. }
_____	Nipples _____	in. at _____	\$ _____
_____	Bushings _____	to _____ in. at _____	\$ _____
_____	Red'g _____		\$ _____
_____	Inc'g _____		\$ _____
_____	Union _____	in. at _____	\$ _____
_____	Meter _____	in. at _____	\$ _____
_____			\$ _____
_____	Compound Joints at _____		\$ _____
_____	Maintenance Foreman _____		\$ _____
_____	Hrs. Water Maint. Man - 1 at _____		\$ _____
_____	Hrs. Water Maint. Man - 2 at _____		\$ _____
_____	Hrs. Garage Foreman _____	at _____	\$ _____
_____	Hrs. Labor _____	at _____	\$ _____
_____	Hrs. Compressor at _____		\$ _____
_____			\$ _____
_____	Trucking _____		\$ _____
_____	Pav't Patch _____		\$ _____
_____			\$ _____
_____			\$ _____
_____			\$ _____
_____			\$ _____

St. Montclair Ave. No. 98  
 Name of Owner \_\_\_\_\_  
12-11-2013

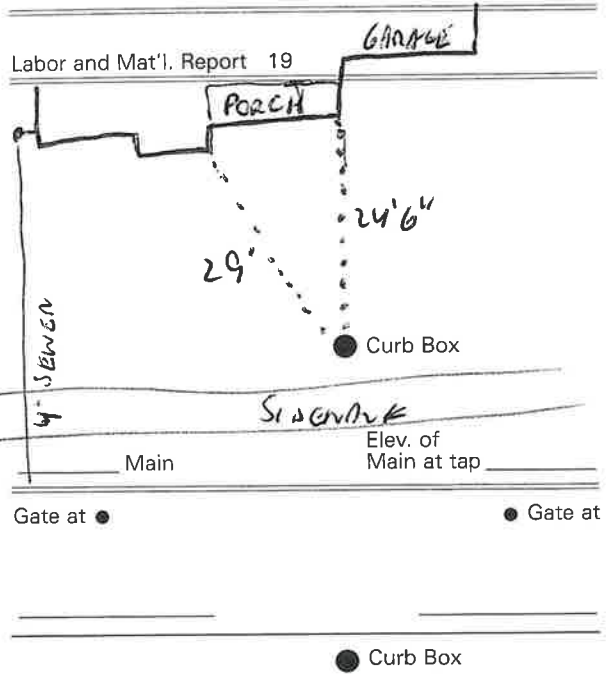

Tax ID# 309.7-12-18.2