

Labor and Materials

1...Copper } Connection $\frac{3}{4}$ "	\$ 1.25
1...Lead } Connection $\frac{3}{4}$ "	\$ 1.70
1...Curb { Cock Valve T.S.&V. } $\frac{3}{4}$ " in	\$ 1.37
1...Service Box { Short $3\frac{1}{2} \times 4\frac{1}{2}$ Long $4\frac{1}{2} \times 5\frac{1}{2}$ Old returned } Buff. or Rdway	\$ 1.08
9 Ft. $\frac{3}{4}$ " in. { Copper Galv. Iron Cast Iron } Pipe at	\$.95
.....Nipplesin. at	\$
1...Bushings $\frac{3}{4}$ " to $\frac{1}{2}$ " in. at	\$
.....Red'g Inc'g } Couplingsto.....in. at	\$
.....Union.....in. at	\$
.....Meter.....in. at	\$
.....Lbs. Br. Stone at	\$
.....Lbs. Sand at	\$
.....Bags Cement at	\$
.....Paving Brick { Mack Red Asphalt } at	\$
.....Lead Joints at	\$
.....Leadite Joints at	\$
7...Hrs. Foreman at $6\frac{1}{2} \times$	\$ 1.25
1...Hrs. Common Labor at 50	\$ 50
7...Hrs. Common Labor at 25	\$ 3.15
.....Hrs. Mason at	\$
.....Hrs. Masons Helper at	\$
.....Hrs. Compressor at	\$
.....Compensation Ins	\$ 19
.....Trucking	\$ 1-
.....Builders Use of Water	\$

Total \$ 11.54


1935-116

Labor and Material Report

Aug 10

1935

$\frac{3}{4}$ " tap at 9 Main rd. at

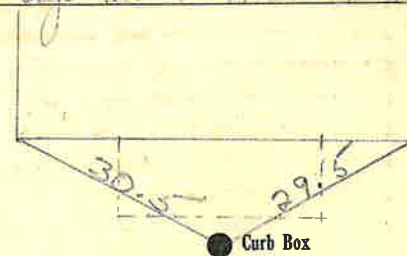

16" Main

Elev. of Main at tap 5

Gate at ●

● Gate at

● Curb Box

old tap shut off
at main

Tax ID# 309.27-2-26

[Handwritten signature]