

Labor and Materials

1	Copper	Connection	3/4 in	\$ 1.25
1	Lead			
1	Curb	Cock Valve T.S.&V.	3/4 in	\$ 1.70
1	Service Box	Short 3 1/2 x 4 1/2		\$ 1.37
	Old returned	Long 4 1/2 x 5 1/2		
23	Ft. 3/4 in.	Copper Galv. Iron Cast Iron	Pipe at 13.7	\$ 3.11
	Nipples		in. at	\$
1	Bushings	3/4 to 1/2 in.	at	\$.05
	Red'g Inc'g	Couplings	to in. at	\$
	Union		in. at	\$
	Meter		in. at	\$
	Lbs. Br. Stone	at		\$
	Lbs. Sand	at		\$
	Bags Cement	at		\$
	Paving Brick	Mack Red Asphalt	at	\$
	Lead Joints	at		\$
	Leadite Joints	at		\$
5 1/2	Hrs. Foreman	at	12 1/2	\$ 3.44
.4	Hrs. Common Labor	at	50	\$ 2.00
21	Hrs. Common Labor	at	45	\$ 9.45
	Hrs. Mason	at		\$
	Hrs. Masons Helper	at		\$
	Hrs. Compressor	at		\$
	Compensation Ins			\$.55
	Trucking			\$ 1.00
	Builders Use of Water			\$


Total \$13.92

335-117

Labor and Material Report

1935

3/4" tap at 10 Mant cabinet

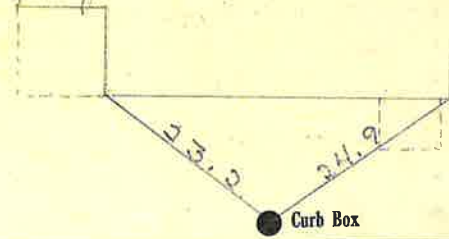

10" Main

Elev. of Main at tap 5

Gate at ●

● Gate at

● Curb Box

old tap shut off at main

Tax ID # 309.27-6-28