

LABOR AND MATERIALS

1	Copper Lead	Connection	$\frac{3}{4}$		\$ 1.23
1	Curb	Cock Valve T. S. & V.	$\frac{3}{4}$	in.	\$ 1.68
1	Service Box	Short	$3\frac{1}{2} \times 4\frac{1}{2}$		\$ 1.54
	Old returned	Long	$4\frac{1}{2} \times 5\frac{1}{2}$		
		Buff. or Rdway			
12	Ft.	$\frac{3}{4}$ in.			
				{ Copper Galv-iron Cast-iron } Pipe at	\$ 2.04
	Nipples	in. at			\$
	Bushings	to in. at			\$
	Red'g Inc'g	Couplings	to in. at		\$
	Union	in. at			\$
	Meter	in. at			\$
	Lead Joints	at			\$
	Leadite Joints	at			\$
	Hrs. Foreman	at			\$
2	Hrs. Chauffeur	at	6x1/2		\$ 1.25
1	Hrs. Tapper	at			\$.63
	Hrs. Labor	at			\$
	Hrs. Labor	at			\$
	Hrs. Compressor	at			\$
	Compensation Ins.				\$.06
	Trucking				\$ 1.-
	Builders Use of Water				\$
	Tap by House				\$
	Patch (1/2 Sutter Dept.)				\$ 2.50
					\$
					\$ 11.93

72 - - 1939

St. 711
Pt. 11
Ave. No. 11


Mounment

Name of Owner

Frank Morris

Labor and Mat'l. Report

Sept 7 1939

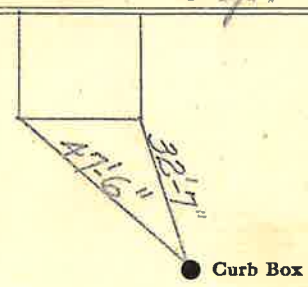

6 Main

Elev. of Main at tap 4

Gate at ●

● Gate at

● Curb Box

Tax ID# 302.11-7-6

New House