

Labor and Materials


1	Copper } Connection.....	3	\$ 1.27
1	Lead }	3	
1	Curb { Cock Valve T.S.&V. }	3	in	\$ 1.70
1	Service Box { Short 3 1/4 x 4 1/2 Long 4 1/2 x 5 1/2 }			\$ 1.45
	Old returned { Buff. or Rdway }			
31	Ft. 3/4 in. { Copper Galv. Iron Cast Iron } Pipe at 13 hrs. A. I. A.			
	Nipples		in. at	\$
	Bushings		to	in. at
	Red'g } Couplings.....		to	in. at
	Inc'g }			\$
	Union.....		in. at	\$
	Meter.....		in. at	\$
	Lbs. Br. Stone at			\$
	Lbs. Sand at			\$
	Bags Cement at			\$
	Paving Brick { Mack Red Asphalt } at			\$
	Lead Joints at			\$
	Leadite Joints at			\$
A	Hrs. Foreman at	62 1/2		\$ 2.50
B	Hrs. Common Labor at	45		\$ 2.60
	Hrs. Common Labor at			\$
	Hrs. Mason at			\$
	Hrs. Masons Helper at			\$
	Hrs. Compressor at			\$
	Compensation Ins			\$ 23
	Trucking			\$ 1-
	Builders Use of Water	Patch		\$ 2.50
Total \$				19.44

1935 - 63

Labor and Material Report

June 11 1935

28 Monument Ave

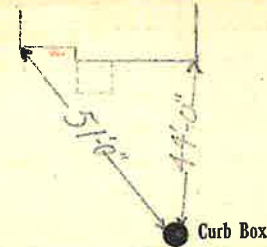

6' Main

Elev of Main at tap 4'

Gate at ●

● Gate at

● Curb Box

New House

Tax 10# 302.11-8-7