


Labor and Materials

Copper } Connection.....	\$.....
Lead }		
Curb { Cock Valve } in	\$.....
	T.S.&V. }	
Service Box { Short 3 1/2 x 4 1/2 }		\$.....
Old returned { Long 4 1/2 x 5 1/2 }		\$.....
	Buff, or Rdway }	
Ft. in. { Copper } Pipe at		\$.....
	Galv. Iron }	
	Cast Iron }	
Nipples	in. at	\$.....
Bushings	to in. at	\$.....
Red'g } Couplings.....	to in. at	\$.....
In'g }		
Union.....	in. at	\$.....
Meter.....	in. at	\$.....
Lbs. Br. Stone at		\$.....
Lbs. Sand at		\$.....
Bags Cement at		\$.....
Paving Brick { Mack } at		\$.....
	Red }	
	Asphalt }	
Lead Joints at		\$.....
Leadite Joints at		\$.....
Hrs. Foreman at		\$.....
Hrs. Common Labor at		\$.....
Hrs. Common Labor at		\$.....
Hrs. Mason at		\$.....
Hrs. Masons Helper at		\$.....
Hrs. Compressor at		\$.....
Compensation Ins		\$.....
Trucking		\$.....
Builders Use of Water		\$.....
Total \$.....		

Labor and Material Report

July 17 1930

29 Monument Ave

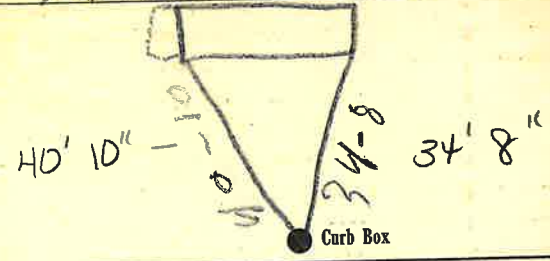

Main Elev of Main at tap _____

Gate at ● ● Gate at _____

● Curb Box

Measurement to No 29
 Monument Ave
 Tax 10 # 302.11-7-25

By Person