


Labor and Materials

4	Copper	Connection	3	\$ 1.50
1	Curb	Cock Valve	3	\$ 1.70
1	Service Box	Short 3 1/2 x 4 1/2		
	Old returned	Long 4 1/2 x 5 1/2		\$ 1.44
30	Ft.	3/4 in. Galv. Iron Pipe	3	\$ 5.70
	Nipples	in. at		\$
	Bushings	to in. at		\$
	Red'g Inc'g	Couplings	to in. at	\$
	Union	in. at		\$
	Meter	in. at		\$
	Lbs. Br. Stone	at		\$
	Lbs. Sand	at		\$
	Bags Cement	at		\$
	Paving Brick	Mack Red Asphalt at		\$
	Lead Joints	at		\$
	Leadite Joints	at		\$
4	Hrs. Foreman	at	6 1/2 hr	\$ 2.50
8	Hrs. Common Labor	at	5 hr	\$ 4.-
8	Hrs. Common Labor	at	4 1/2 hr	\$ 3.60
	Hrs. Mason	at		\$
	Hrs. Masons Helper	at		\$
	Hrs. Compressor	at		\$
	Compensation Ins			\$ 0.36
	Trucking			\$ 1.-
	Builders Use of Water	Raw Patch		\$ 5.-
Total				\$ 26.80

30 Monument Ave

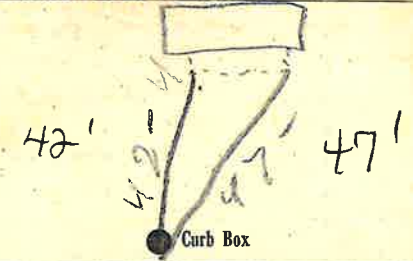

Main Elev. of Main at tap
 Gate at ● Gate at ●

● Curb Box
old shut off at main
 Holmquist
 Tax ID # 302.11-8-6