

## LABOR AND MATERIALS


Copper	}	Connection.....			\$
Lead					
Curb	{	Cock Valve T. S. & V. }	..... in.		\$
Service Box Old returned			{	Short 3 $\frac{1}{2}$ x4 $\frac{1}{2}$	
	Long 4 $\frac{1}{2}$ x5 $\frac{1}{2}$				
		Buffer Rdway			\$
Ft. .... in.	{	Copper Galv Iron Cast Iron }	Pipe at .....		\$
Nipples .....			in. at .....		\$
Bushings .....			to .....	in. at .....	
Red'g Inc'g	}	Couplings .....	to .....	in. at .....	\$
Union .....			in. at .....		\$
Meter .....	in. at .....			\$	
Lead Joints at .....				\$	
Leadite Joints at .....				\$	
Hrs. Foreman at .....				\$	
Hrs. Chauffeur at .....				\$	
Hrs. Tapper at .....				\$	
Hrs. Labor at .....				\$	
Hrs. Labor at .....				\$	
Hrs. Compressor at .....				\$	
Compensation Ins. ....				\$	
Trucking .....				\$	
Builders Use of Water .....				\$	
				\$	
				\$	
Monument

St.  
Pl.  
Ave. No. 31

Name of Owner

Labor and Mat'l. Report AUG 23 1939 19

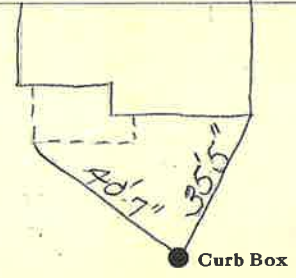

Main Elev. of  
Main at tap.....

---

Gate at ● ● Gate at

● Curb Box

Tax 10# 302.11-7-26