

NEW CURB BOX

LABOR AND MATERIALS

Copper	} Connection	_____	\$	_____			
Lead							
Curb	} Cock Valve T. S. & V.	} _____ in.	\$	_____			
Service box	} Short 3½ x 4½	} _____	\$	_____			
Old returned					Long 4½ x 5½		
					Buff or Rdway		
30 Ft. 6 in.	} Copper	} Pipe at _____	\$	_____			
					C.I.		
					C.I.		
Nipples	_____ in. at _____	\$	_____				
Bushings	_____ to _____ in. at _____	\$	_____				
Red'g	} Coupl'gs _____ to _____ in. at _____	\$	_____				
Inc'g							
Union	_____ in. at _____	\$	_____				
Meter	_____ in. at _____	\$	_____				
Lead Joints	_____ at _____	\$	_____				
Compound Joints	_____ at _____	\$	_____				
Maintenance Foreman	_____ at _____	\$	_____				
Hrs. Water Maint. Man-1	_____ at _____	\$	_____				
Hrs. Water Maint. Man-2	_____ at _____	\$	_____				
Hrs. Garage Foreman	_____ at _____	\$	_____				
Hrs. Labor	_____ at _____	\$	_____				
Hrs. Compressor	_____ at _____	\$	_____				
Compensation Ins. at \$	_____ per C	\$	_____				
Trucking	_____ at _____	\$	_____				
Pav't Patch	_____ at _____	\$	_____				
		\$	_____				
		\$	_____				
		\$	_____				
		\$	_____				
O'head	_____ at _____	\$	_____				
		\$	_____				


MONUMENT

St. _____
Pl. _____
Ave. No. **32**

Name of Owner _____

Labor and Mat'l. Report

7/9 19 80

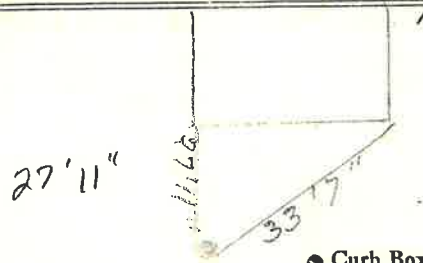

● Curb Box

6 Main
Gate at ●

Elev. of Main at tap **5**
● Gate at

● Curb Box **NEW**

Tax ID# 302.11-8-5