

Labor and Materials

1	Copper	Connection	3	\$ 1.46
1	Curb	Cock Valve	3	\$ 1.93
1	Service Box	Short 3 1/2 x 4 1/2		\$ 1.77
30	Ft.	Copper Galv. Iron Cast Iron	3	\$ 6.60
	Nipples	in. at		\$
	Bushings	to in. at		\$
	Red's Inc's	Conplings to in. at		\$
	Union	in. at		\$
	Meter	in. at		\$
	Lead Joints	at		\$
	Leadite Joints	at		\$
1	Hrs. Foreman	at	3 1/2	\$.31
4	Hrs. Chauffeur	at	1 1/2	\$ 2.50
	Hrs. Tapper	at		\$ 3.60
8	Hrs. Labor	at	45	\$ 6.40
	Hrs. Labor	at		\$
	Hrs. Compressor	at		\$
	Compensation Ins.			\$.20
	Trucking			\$ 1.00
	Builders Use of Water			\$
	Truck	1038 Bus		\$ 7.50
	Taps by Penner			\$
				\$

165-1937

St.
Pt.
Ave. No. 34


Name of Owner

Sunberg

Labor and Mat'l. Report

Dec

1937

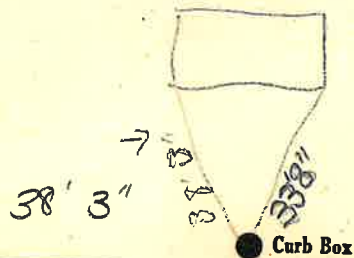

6 Main

Elev. of Main at tap 4 1/2

Gate at ●

● Gate at

● Curb Box

New House

Tax ID # 302.11-8-4

1/1