


Labor and Materials

Copper } Connection.....	$\frac{3}{4}$	\$ 96
Lead }	$\frac{3}{4}$	
Curb { Cock Valve }	$\frac{3}{4}$	\$ 1.33
{ T.S. & V. }	$\frac{3}{4}$	
Service Box { Short $3\frac{1}{2} \times 4\frac{1}{2}$ }		\$ 1.35
Old returned { Long $4\frac{1}{2} \times 6\frac{1}{2}$ }		
{ Buff. or R. lwr. }		
28 Ft. $3\frac{1}{4}$ in. { Copper Galv. Iron Cast Iron } Pipe at	15	\$ 4.20
Nipples	in. at	\$
Bushings	to	in. at \$
Red'g } Couplings.....	to	in. at \$
Inc'g }		
Union.....	in. at	\$
Meter.....	in. at	\$
Lbs. Br. Stone at		\$
Lbs. Sand at		\$
Bags Cement at		\$
Paving Brick { Mack Red Asphalt } at		\$
Lead Joints at		\$
Leadite Joints at		\$
3 Hrs. Foreman at	$3\frac{1}{2}$	\$ 1.88
4 Hrs. Common Labor at		\$ 2.50
Hrs. Common Labor at		\$
Hrs. Mason at		\$
Hrs. Masons Helper at		\$
Hrs. Compressor at		\$
Compensation Ins		\$ 1.12
Trucking		\$ 1.00
Builders Use of Water $\frac{1}{2}$ Sewer		\$ 2.50
Total \$		15.34

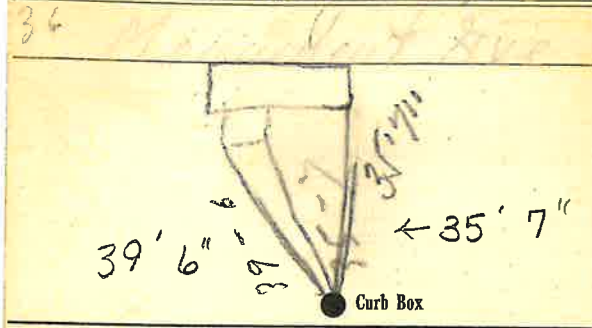

Main Elev. of Main at tap 45

Gate at ● ● Gate at

● Curb Box

New House

Tax ID # 302.11-8-3