

LABOR AND MATERIALS

1	Copper Lead	Connection	3/4"	\$	3.04
1	Curb	Cock Valve T. S. & V.	3/4 in.	\$	3.54
1	Service box Old returned	Short 3/2x4 1/2 Long 4 1/2x5 1/2 Buff or Rdway		\$	4.70
12	Ft.	Copper G. I. G. I.	3/4 in. Pipe at 35	\$	4.20
	Nipples	in. at		\$	
	Bushings	to in. at		\$	
	Red'g In'g	Coupl'gs to in. at		\$	
	Union	in. at		\$	
	Meter	in. at		\$	
	Lead Joints at			\$	
	Compound Joints at			\$	
4	Hrs. Water Maint. Man	1 at		\$	4.92
3	Hrs. Water Maint. Man	2 at 1.35		\$	4.00
	Hrs. Labor	at		\$	
8	Hrs. Labor	at 1.02		\$	8.16
2	Hrs. Compressor at			\$	
	Compensation Ins. at \$	per C.		\$	46
	Trucking			\$	1.00
	Pav't Patch			\$	22.50
	O'head			\$	
				\$	56.52

Top made by Miller
Oct 17-1951

187-1951


Monument St. Pl. Ave. No. 39

Name of Owner

Koppel

Labor and Mat'l. Report

Oct 17 1951

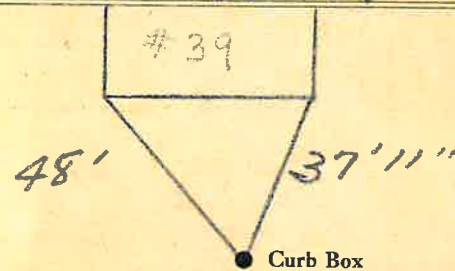

6" Main

Elev. of Main at tap 5'

Gate at ●

● Gate at

● Curb Box

TAX ID # 302.11-7-30