

### LABOR AND MATERIALS


1	Copper Lead	{ Connection	3/4"	\$	2.04
1	Curb	{ Cock Valve T.S. & V.	3/4 in.	\$	3.54
1	Service box - Old returned	{ Short 3 1/2 x 4 1/2 Long 4 1/2 x 5 1/2 Buff or Rdway		\$	4.70
10	Ft. 3/4 in.	{ Copper G.I. C.I. } Pipe at	35	\$	3.50
	Nipples	in. at		\$	
	Bushings	to in. at		\$	
	Red'g Inc'g	{ Coupl'gs to in. at		\$	
	Union	in. at		\$	
	Meter	in. at		\$	
	Lead Joints	at		\$	
	Compound Joints	at		\$	
3	Hrs. Water Maint. Man-1	at	1.23	\$	3.69
3	Hrs. Water Maint. Man-2	at	1.13	\$	3.39
16	Hrs. Labor	at	1.02	\$	16.32
	Hrs. Labor	at		\$	
	Hrs. Compressor	at		\$	
	Compensation Ins.	at \$ 2.66 per C.		\$	6.2
	Trucking			\$	1.00
	Pav't Patch	EXT. of Main		\$	
	O'head			\$	
	Tap by Gifford			\$	39.90
					7-5-51

70-1951

MONUMENT St. Pl. Ave. No. 43

Name of Owner Koppel

Labor and Mat'l. Report July 5 19 51

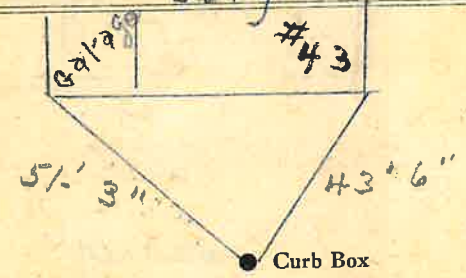

6" Main Elev. of Main at tap 5'

Gate at • Gate at

• Curb Box

Tax ID # 302.11-7-32