

Labor and Materials

1	Copper	Connection	3/4"		\$ 1.46	
	Lead					
1	Curb	Cock	3/4" in		\$ 1.93	
		Valve				
		T. S. & V.				
1	Service Box	Short	3 1/2 x 4 1/2	\$ 1.77		
	Old-returnd	Long	4 1/2 x 5 1/2			
		Buff. or Rdway				
1.0	Ft. 3/4"	Copper	} Pipe at 22	\$ 3.20		
		Galv. Iron				
		Cast Iron				
	Nipples	in. at				
	Bushings	to	in. at			
	Red'g	} Conplings	to	in. at		
	Inc'g					
	Union	in. at				
	Meter	in. at				
	Lead Joints	at				
	Leadite Joints	at				
2	Hrs. Foreman	at	3 1/4		\$.63	
3	Hrs. Chauffeur	at	6 2/3		\$ 1.88	
	Hrs. Tapper	at				
1	Hrs. Labor	at	45		\$ 45	
	Hrs. Labor	at			\$ 2.96	
	Hrs. Compressor	at				
	Compensation Ins.				\$.09	
	Trucking				\$ 1.00	
	Builders Use of Water		Patch (Sewer)		\$ 2.50	
			Tap made by Power			
					\$ 13.91	

27-1937

St.

-Pt.


Ave. No. 17

Name of Owner

Norris

Labor and Mat'l. Report June 9

1937

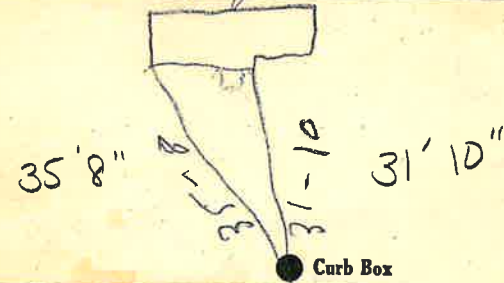

Main

Elev. of

Main at tap

Gate at ●

● Gate at

● Curb Box

New House

ID # 302.11-7-20