

### Labor and Materials


1	Copper Lead	Connection	3	\$	1.46
1	Curb	Cock Valve	4	\$	1.93
1	Service Box Old returned	Short 3" x 4 1/2" Long 4 1/2" x 5 1/2" Buff - Rdway		\$	1.77
28	Ft.	Copper Galvanized Cast Iron	Pipe at 3/4"	\$	6.16
	Nipples	in. at		\$	
	Bushings	to in. at		\$	
	Red'g Inc'g	Conplings to in. at		\$	
	Union	in. at		\$	
	Meter	in. at		\$	
	Lead Joints	at		\$	
	Leadite Joints	at		\$	
	Hrs. Foreman	at		\$	
5	Hrs. Chauffeur	at 6.25		\$	3.13
4	Hrs. Tapper	at 6.25		\$	2.50
5	Hrs. Labor	at 4.5		\$	22.5
	Hrs. Labor	at		\$	
	Hrs. Compressor	at		\$	
	Compensation Ins.			\$	1.24
	Trucking			\$	1.00
	Builders Use of Water	Batch (Sewer)		\$	2.50
		Tip made by Person		\$	
				\$	
				\$	
				\$	22.94

3 2-1937

St. \_\_\_\_\_  
Pl. \_\_\_\_\_  
Ave. No. 18

Name of Owner  
Ernest N. Noreau

Labor and Mat'l. Report June 16, 1937

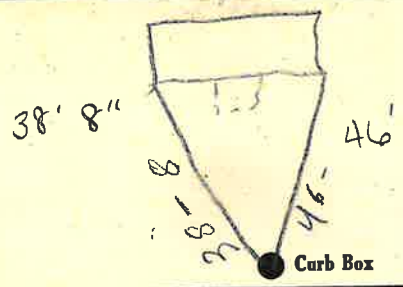

6 Main Elev. of Main at tap 4 1/2

Gate at • Gate at

● Curb Box

New House  
Tax ID# 302.11-8-11