


Labor and Materials

Copper } Connection.....	3	\$ 1.33
Lead }	4	
Curb { Cock }	3	\$ 1.58
{ Valve }	4	
{ T.S.&V. }		
Service Box { Short 3 1/2 x 4 1/2 }		\$ 1.36
Old returned { Long 4 1/2 x 5 1/2 }		
{ Buff. or Rdway }		
29 Ft. in. { Copper } Pipe at	3	\$ 2.76
{ Galv. Iron }	4	
{ Cast Iron }		
Nipples in. at		\$
Bushings to in. at		\$
Red'g } Couplings..... to in. at		\$
Inc'g }		
Union..... in. at		\$
Meter..... in. at		\$
Lbs. Br. Stone at		\$
Lbs. Sand at		\$
Bags Cement at		\$
Paving Brick { Mack } at		\$
{ Red }		
{ Asphalt }		
Lead Joints at		\$
Leadite Joints at		\$
3 Hrs. Foreman at		\$ 1.88
1 1/2 Hrs. Common Labor at <i>Tapper</i>		\$ 3.25
Hrs. Common Labor at		\$
Hrs. Mason at		\$
Hrs. Masons Helper at		\$
Hrs. Compressor at		\$
Compensation Ins		\$.16
Trucking		\$
Builders Use of Water <i>Patch</i>		\$ 2.50
Total \$		15.47

3

33-34
Labor and Material Report June 23 1933

20 Monument Ave

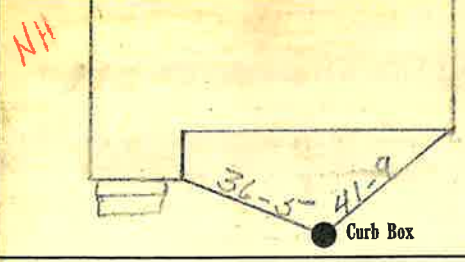

6' Main Elev. of Main at tap 4 1/2

Gate at ● Gate at ●

● Curb Box

Tax ID # 302.11-8-10

[Handwritten signature]