


Labor and Materials

Copper } Connection.....	3	\$.....
Lead }	4	\$.....
Curb { Cock }	3	\$.....
{ Valve }		
{ T.S.&V. }		
Service Box { Short 3 1/2 x 4 1/2 }		\$.....
{ Long 4 1/2 x 5 1/2 }		\$.....
{ Bull. or Redway }		\$.....
12 Ft. in. { Copper } Pipe at	3	\$.....
{ Galv. Iron }		
{ Cast Iron }		
Nipples in. at		\$.....
Bushings to in. at		\$.....
Red'g } Couplings..... to in. at		\$.....
Inc'g }		
Union..... in. at		\$.....
Meter..... in. at		\$.....
Lbs. Br. Stone at		\$.....
Lbs. Sand at		\$.....
Bags Cement at		\$.....
Paving Brick { Mack } at		\$.....
{ Red }		
{ Asphalt }		
Lead Joints at		\$.....
Leadite Joints at		\$.....
Hrs. Foreman at		\$.....
Hrs. Common Labor at		\$.....
Hrs. Common Labor at		\$.....
Hrs. Mason at		\$.....
Hrs. Masons Helper at		\$.....
Hrs. Compressor at		\$.....
Compensation Ins		\$.....
Trucking		\$.....
Builders Use of Water		\$.....
Total \$.....		

33-11

Labor and Material Report *Mar 28 1933*

21 *MONUMENT AVE*

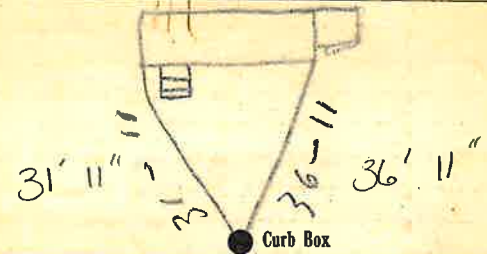

4 Main Elev. of Main at tap *3-10*

Gate at ● ● Gate at

● Curb Box

Tax ID# 302.11-7-22
New House

(initials)